


B	28.10.2024	ISSUED FOR APPROVAL			UNK	MM	GC	
A	23.09.2024	ISSUED FOR APPROVAL			UNK	MM	GC	
REV	DATE	DESCRIPTION			MOD.BY	CKD.BY	APP.BY	
REVISIONS								
		SHIP JP 88 STORK						
		TITLE WIRING DIAGRAM OF POWER SYSTEM						
SCALE NTS		DRAWN	UNK	DRAWING NUMBER		HULL NUMBER		REV
		CHECKED	MM	GSPL-P1482-EL-0003		-----		B
SIZE A4		VERIFIED	GC	DATE:— 28.10.2024		SHEET:— 01/12		

REV.	DESCRIPTIONS	REMARKS	DATE	BY
1	REVISE ACC. TO OWNER'S COMMENTS		28/6/05	W.D
2	REVISE ACC. TO EQPT. INFO.		1/9/05	W.D
<p>NOTES:</p> <p>MODIFICATIONS ARE MARKED IN RED FONT.</p> <p>MODIFIED ON PAGE 10 OF 18.</p>				
<p>FOR CONSTRUCTION</p> <p>01 SEP 2005</p>				

FOR CONSTRUCTION  
01 SEP 2005

Appr/Contr/Ref/Fly	A	C	F
NO. OF PRINT	8	9	9
DATE	20/5	29/6	1/9
REVISION	0	1	2
OWNER	2	2	2
CLASS	5	-	-
PJS	1	1	1
COM (SB)	-	1	1
QC	-	1	1
PRODUCTION	-	4	4

[illegible]

# PanUnited

PROJECT : 70M 12,000 BHP AHTS VESSEL

DRAWN BY: Wu Die

APPROVED BY:-


OWNER LEWEK

CLASS LRS

CLASS LRS


### SINGLE LINE DIAGRAM – MAIN SWITCHBOARD



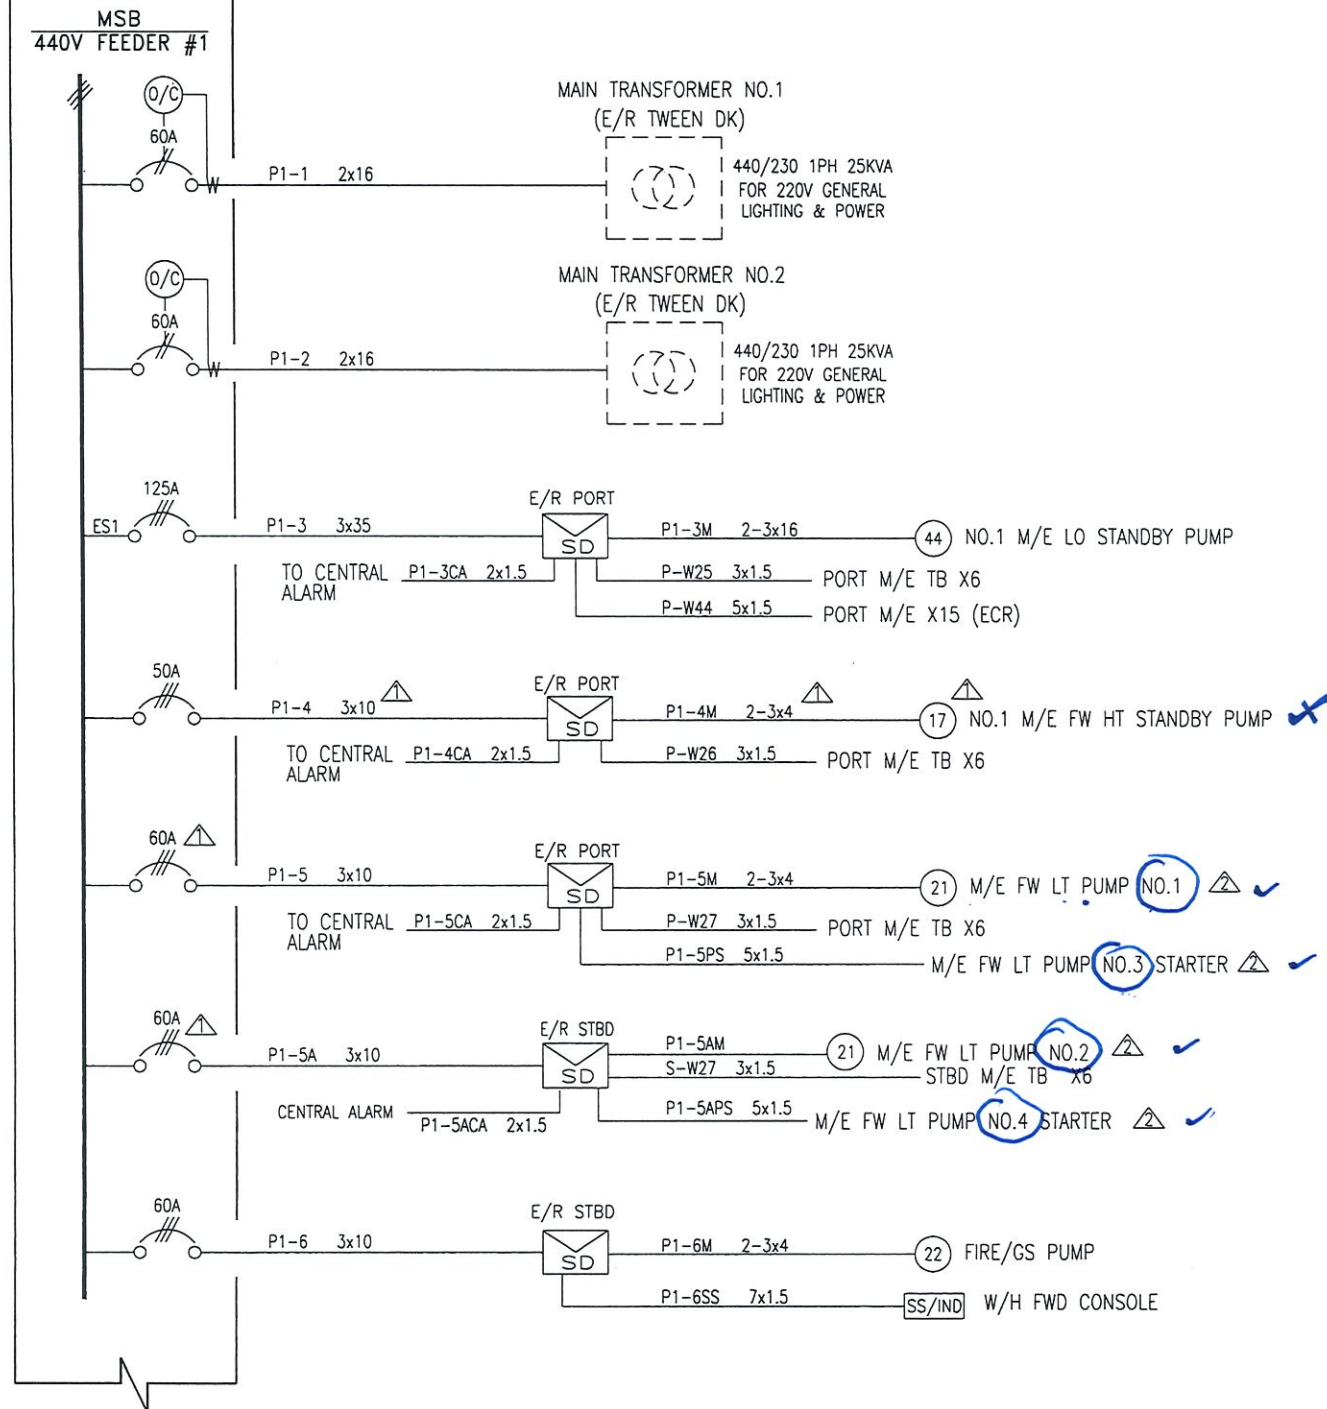


Pan-United Marine Limited		
PROJECT : 70M 12,000BHP AHTS VESSEL		
TITLE : SINGLE LINE DIAGRAM - MAIN SWBD (NO.1 440/3/60 DISTR. PANEL)		
PROJECT NO :	HULL 165/169	SCALE : NA
DRAWING NO :	E102	SHEET : 5 OF 18

MSB  
440V FEEDER #1

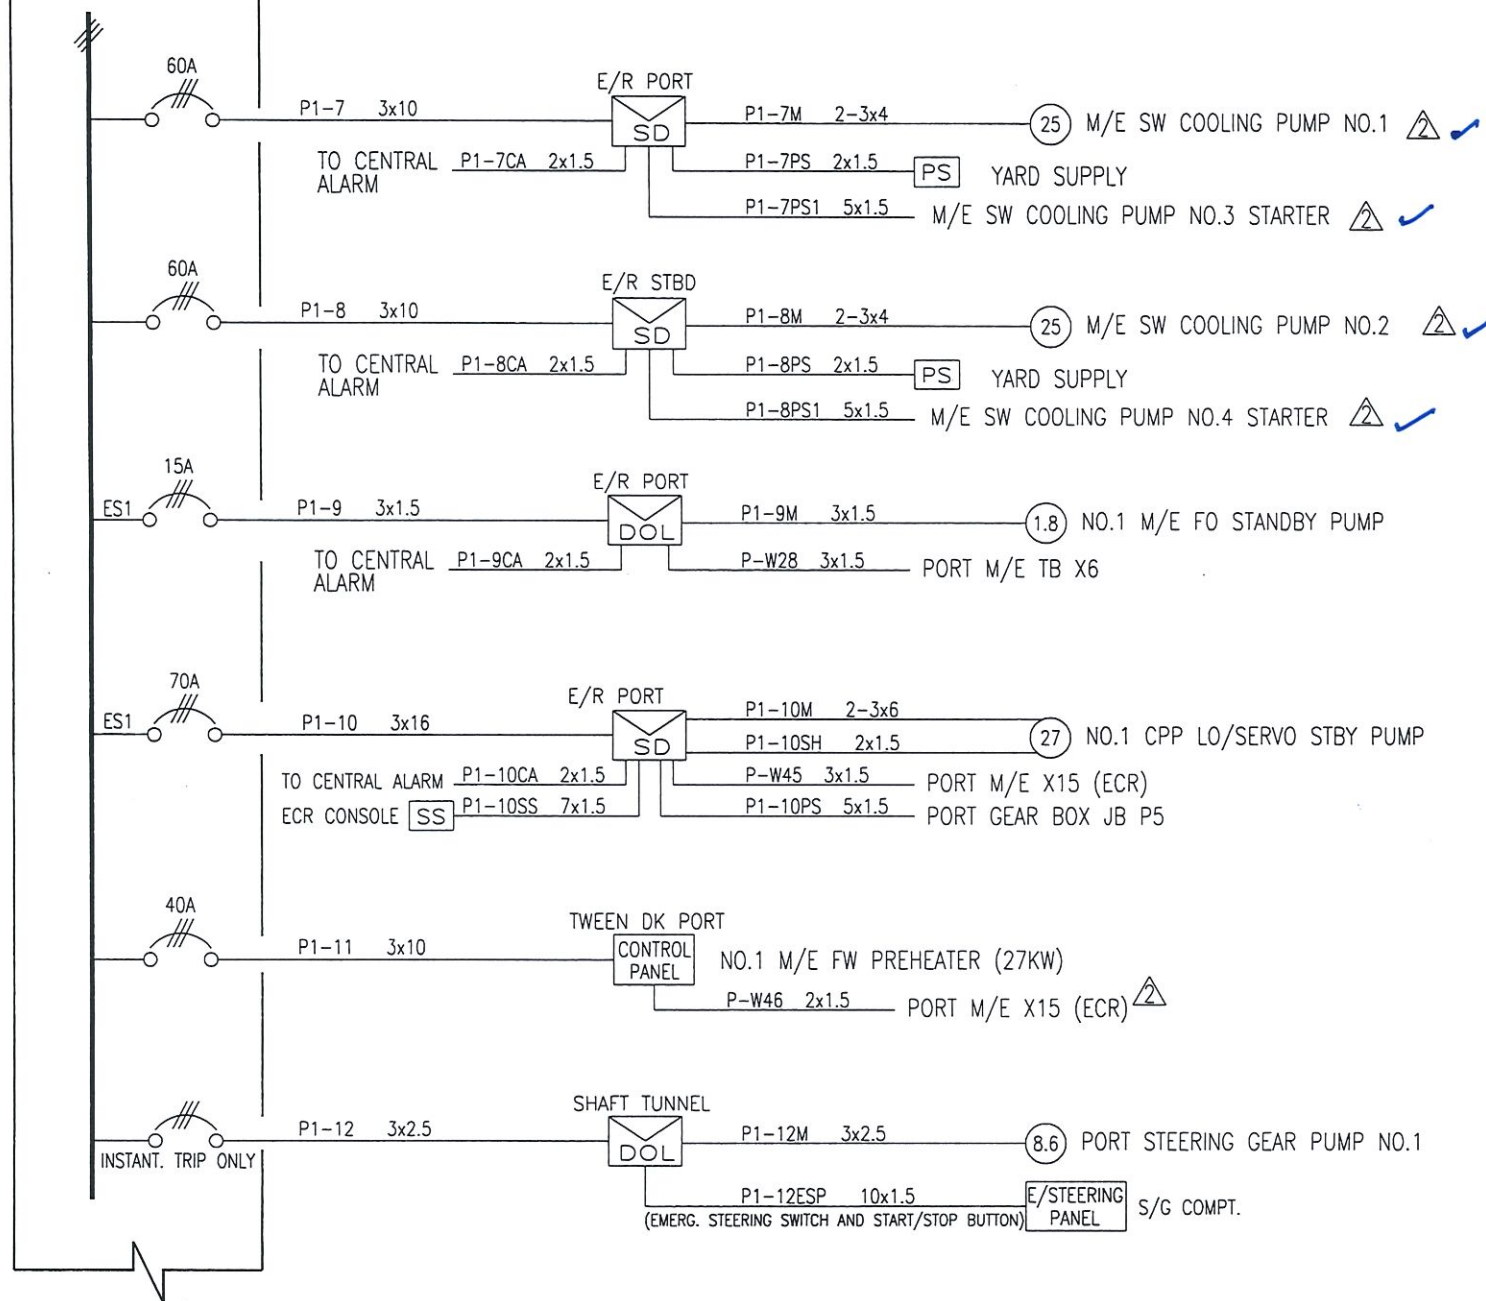


Pan-United Marine Limited	
PROJECT : 70M 12,000BHP AHTS VESSEL	
TITLE : SINGLE LINE DIAGRAM - MAIN SWBD (NO.1 440/3/60 DISTR. PANEL)	
PROJECT NO : HULL 165/169	SCALE : NA
DRAWING NO : E102	SHEET : 6 OF 18

MSB  
440V FEEDER #1

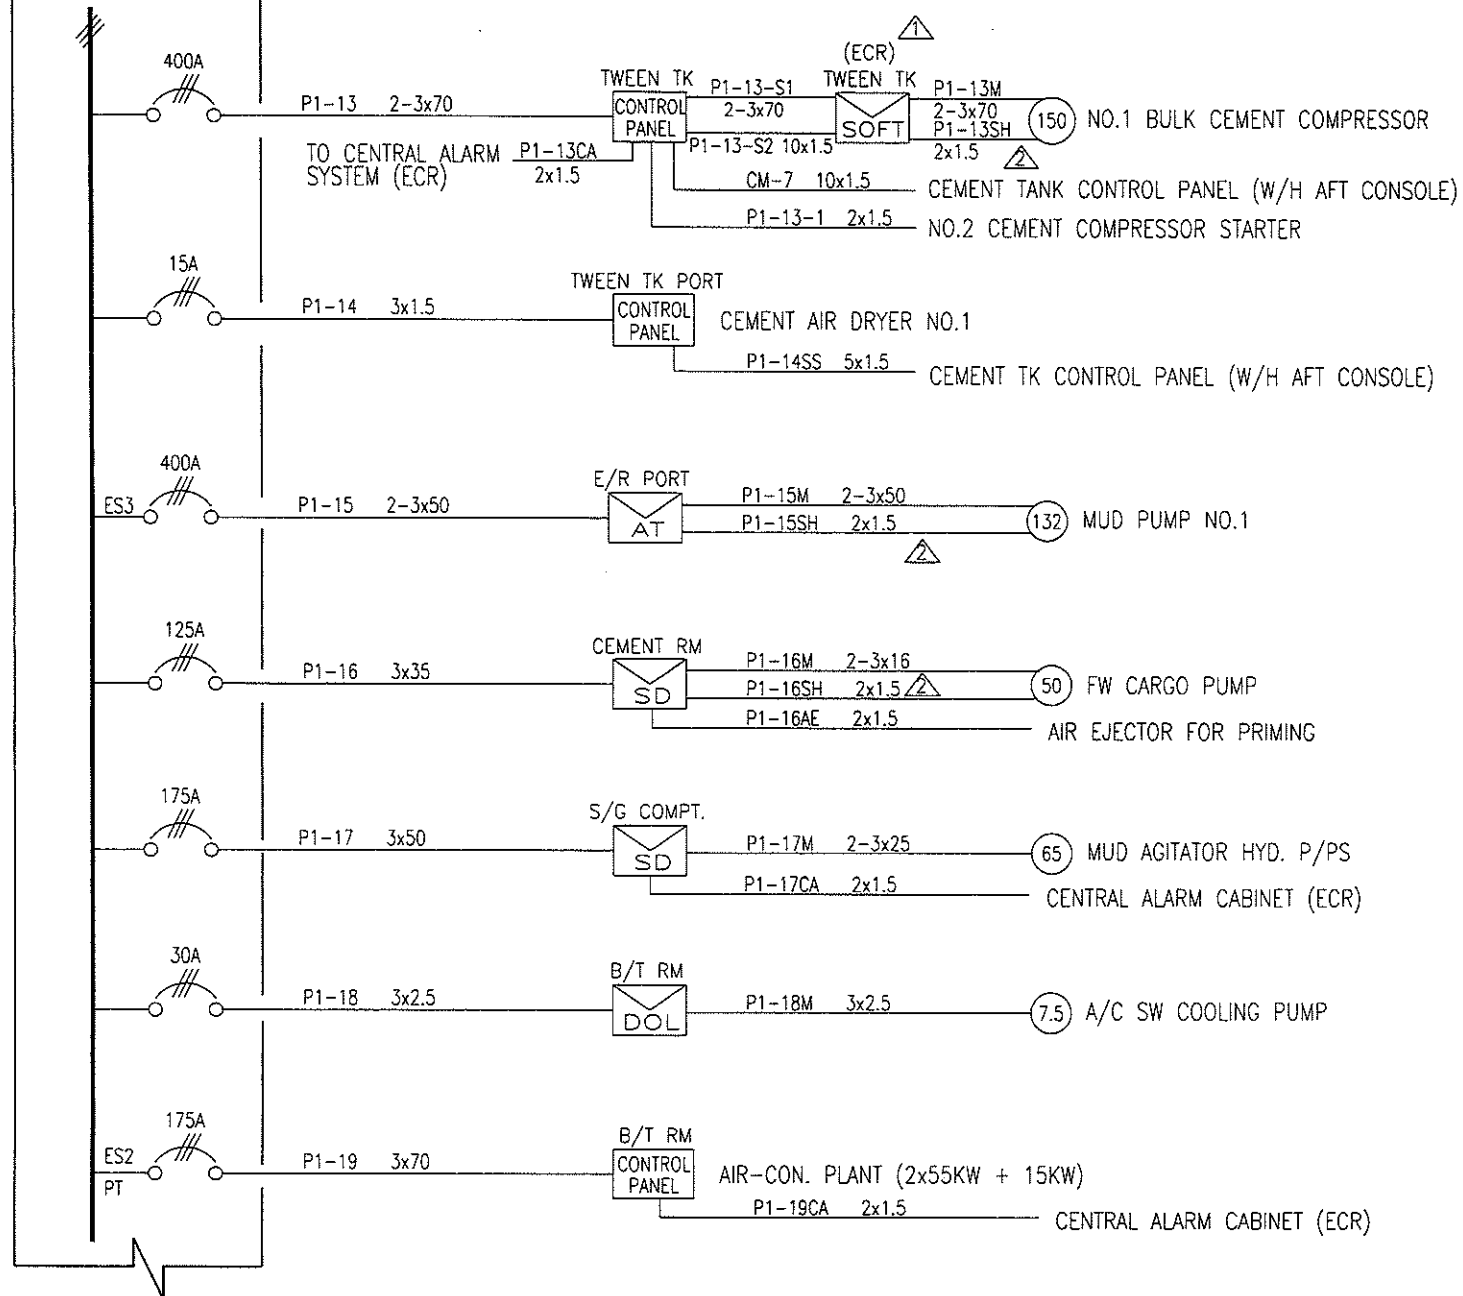

Pan-United Marine Limited	
PROJECT : 70M 12,000BHP AHTS VESSEL	
TITLE : SINGLE LINE DIAGRAM - MAIN SWBD (NO.1 440/3/60 DISTR. PANEL)	
PROJECT NO : HULL 165/169	SCALE : NA
DRAWING NO : E102	SHEET : 7 OF 18

MSB  
440V FEEDER #1

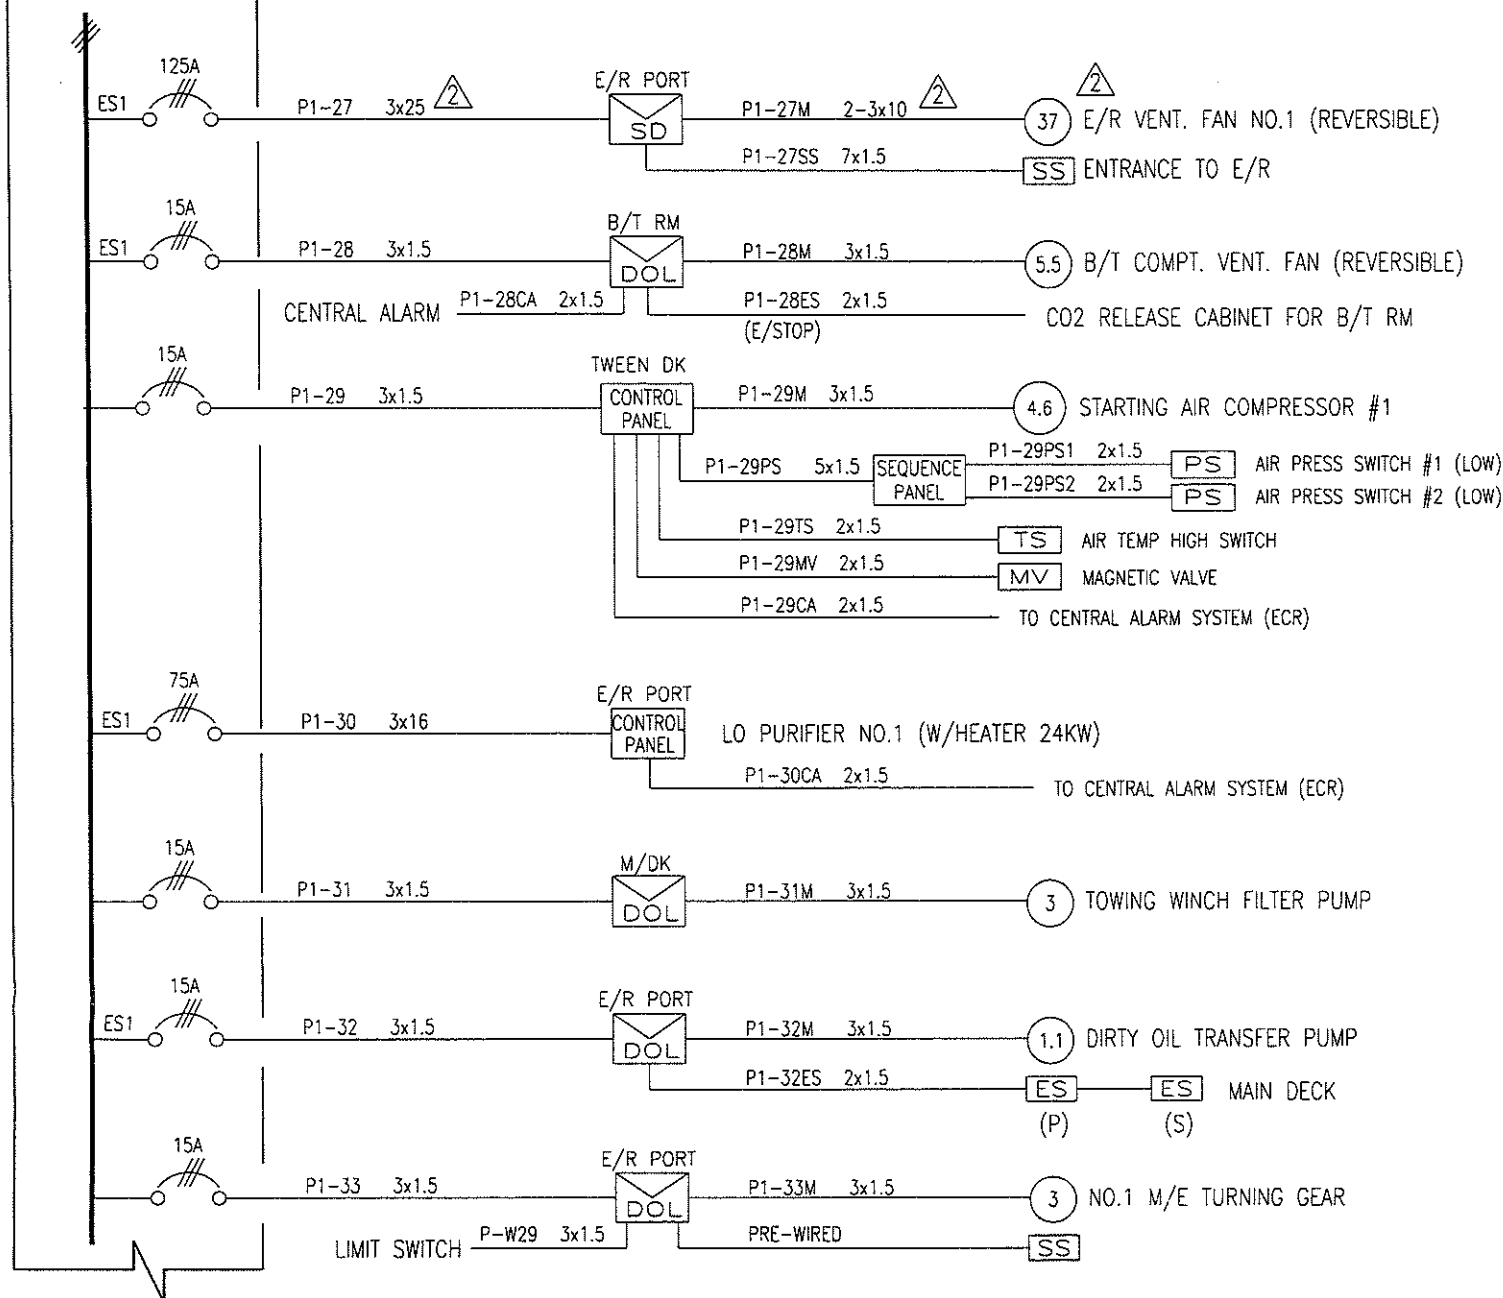

Pan-United Marine Limited

PROJECT : 70M 12,000BHP AHTS VESSEL

TITLE : SINGLE LINE DIAGRAM - MAIN SWBD  
(NO.1 440/3/60 DISTR. PANEL)


PROJECT NO : HULL 165/169

SCALE : NA

DRAWING NO : E102


SHEET : 9 OF 18



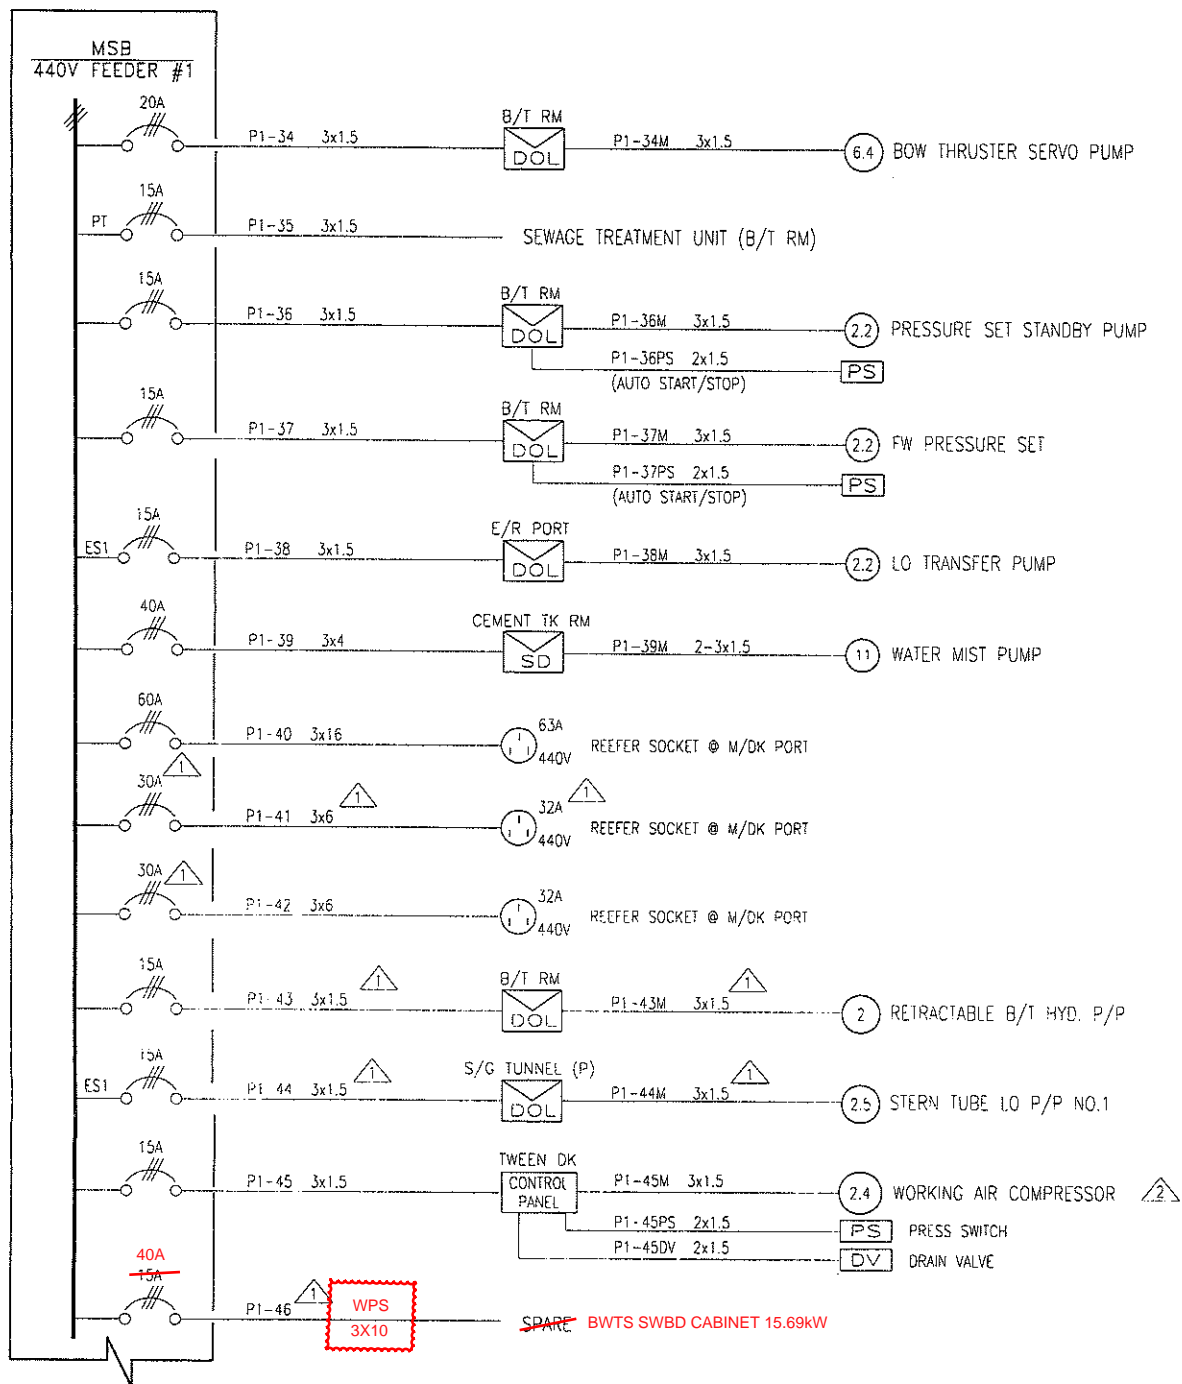

Pan-United Marine Limited		
PROJECT :	70M 12,000BHP AHTS VESSEL	
TITLE :	SINGLE LINE DIAGRAM - MAIN SWBD (NO.1 440/3/60 DISTR. PANEL)	
PROJECT NO :	HULL 165/169	SCALE : NA
DRAWING NO :	E102	SHEET : 10 OF 18



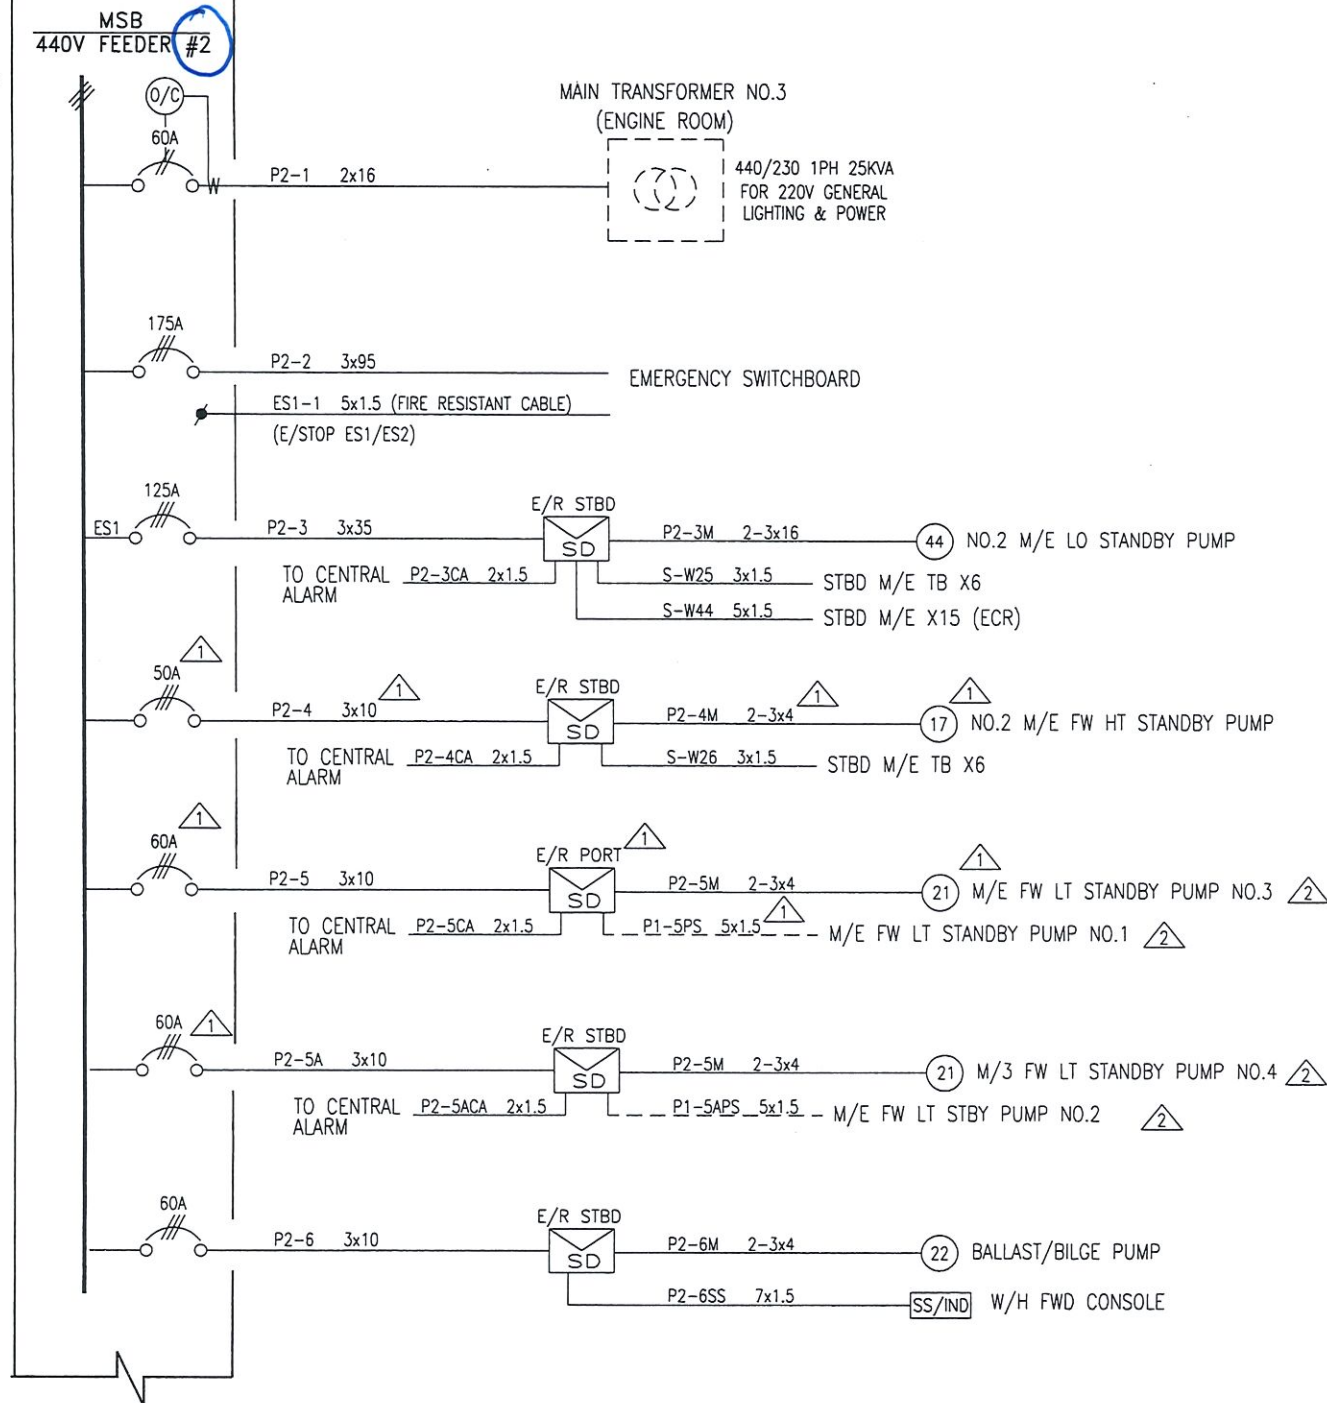

Pan-United Marine Limited

PROJECT : 70M 12,000BHP AHTS VESSEL


TITLE : SINGLE LINE DIAGRAM - MAIN SWBD  
(NO.2 440/3/60 DISTR. PANEL)

PROJECT NO : HULL 165/169

SCALE : NA


DRAWING NO : E102

SHEET : 11 OF 18

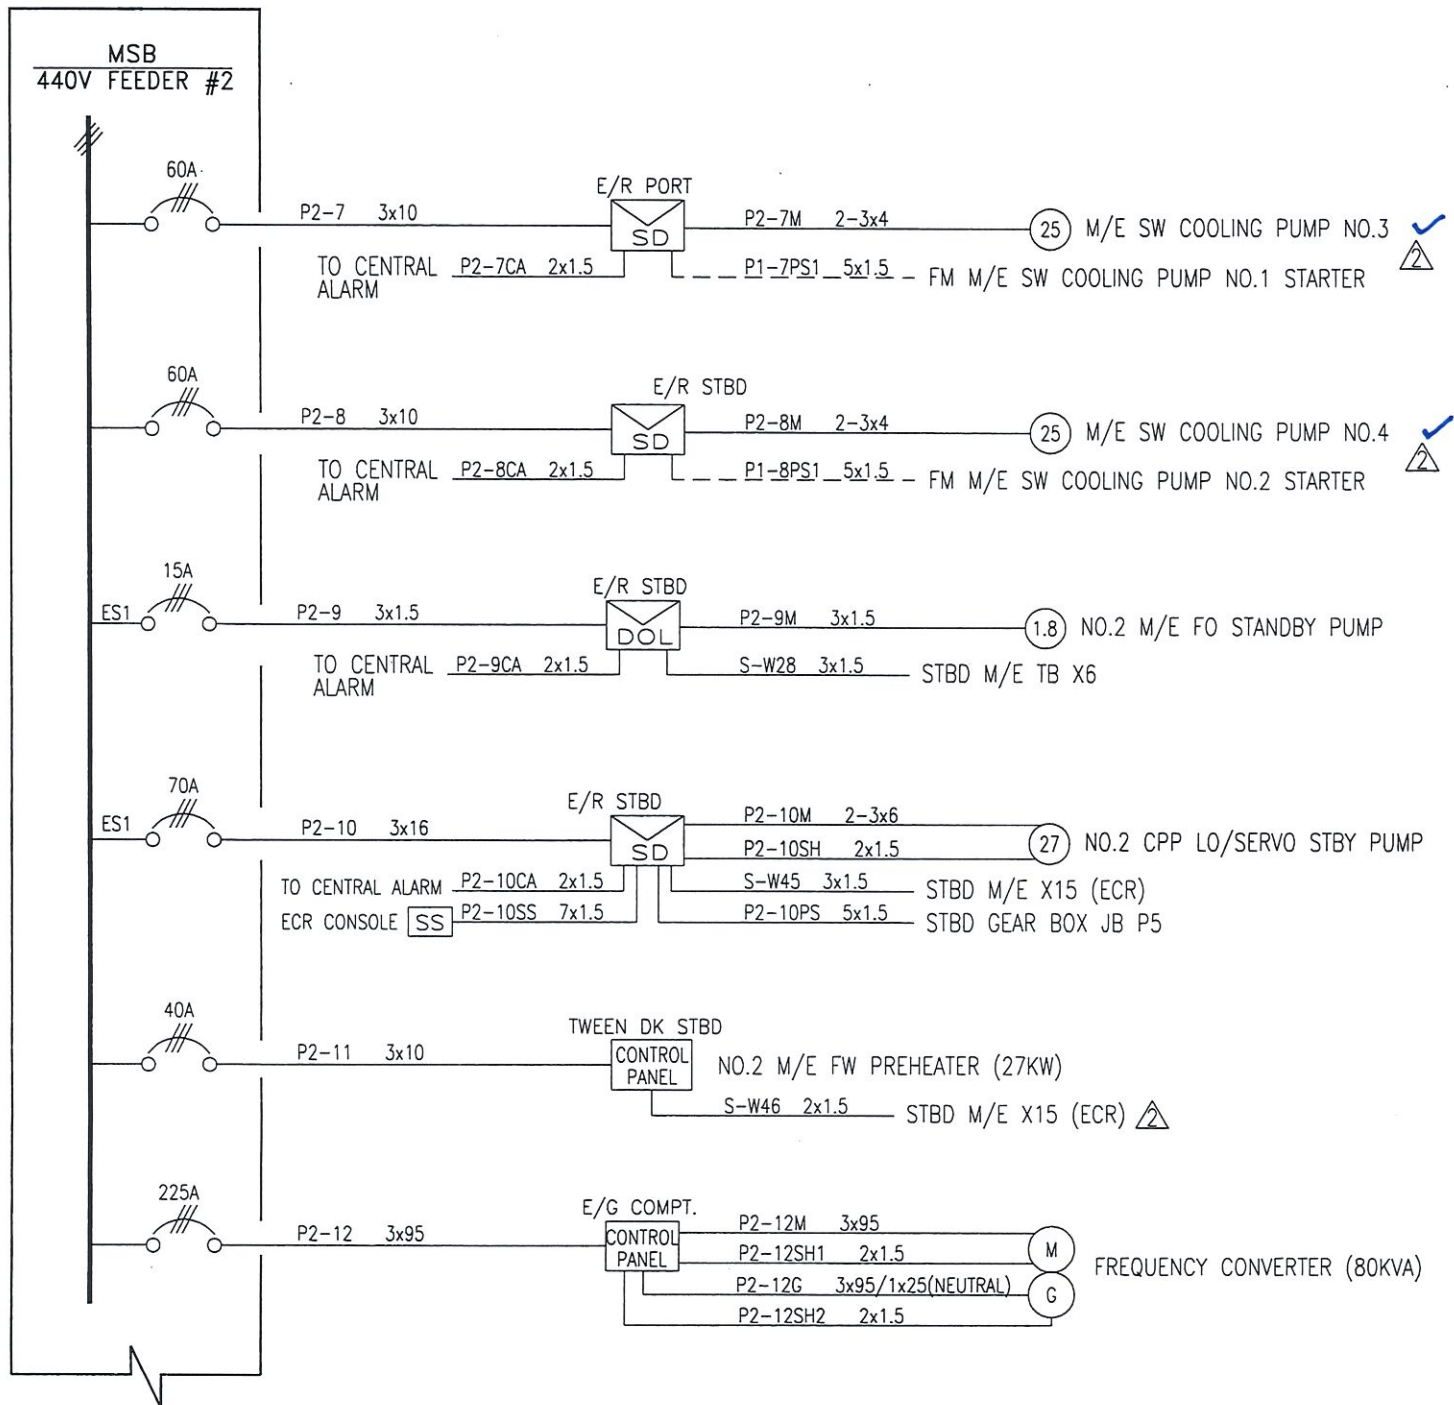


Pan-United Maine Limited		
PROJECT : 70M 12,000BHP AHTS VESSEL		
TITLE : SINGLE LINE DIAGRAM - MAIN SWBD (NO.2 440/3/60 DISTR. PANEL)		
PROJECT NO :	HULL 165/169	SCALE : NA
DRAWING NO :	E102	SHEET : 12 OF 18

MSB  
440V FEEDER #2

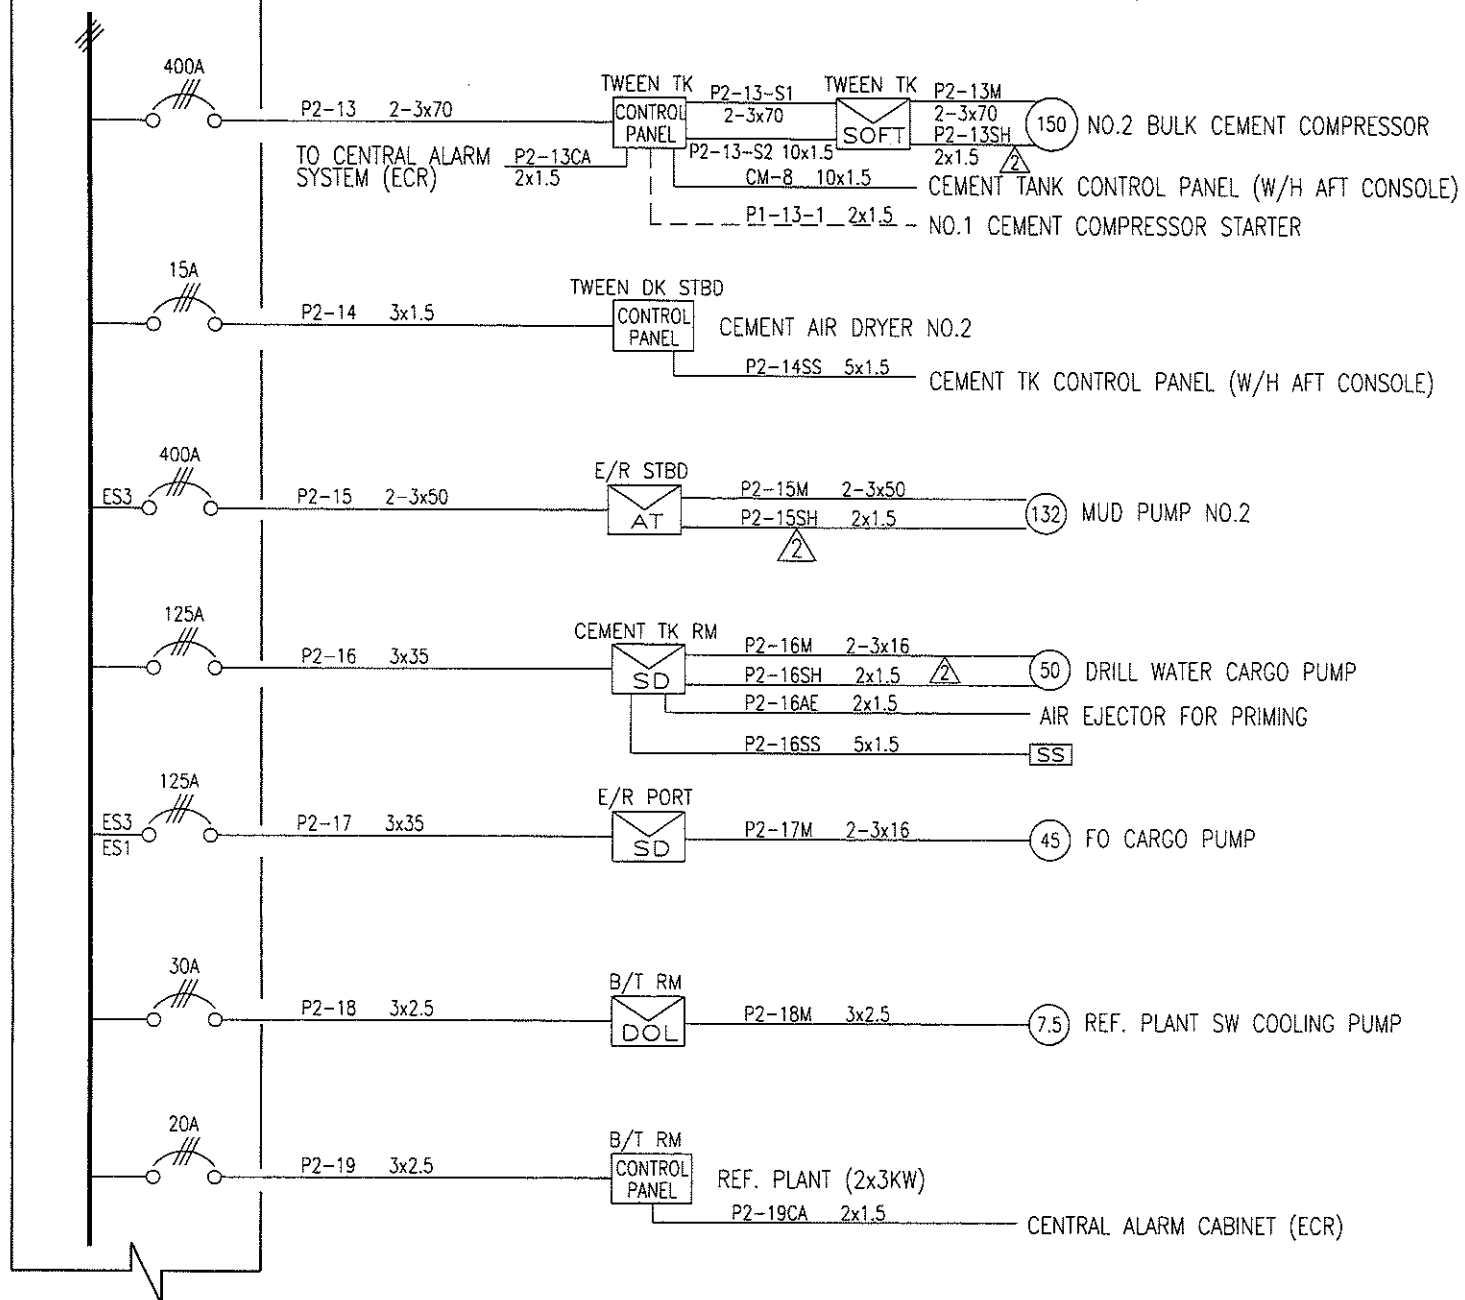

Pan-United Marine Limited	
PROJECT : 70M 12,000BHP AHTS VESSEL	
TITLE : SINGLE LINE DIAGRAM - MAIN SWBD (NO.2 440/3/60 DISTR. PANEL)	
PROJECT NO : HULL 165/169	SCALE : NA
DRAWING NO : E102	SHEET : 13 OF 18

MSB  
440V FEEDER #2

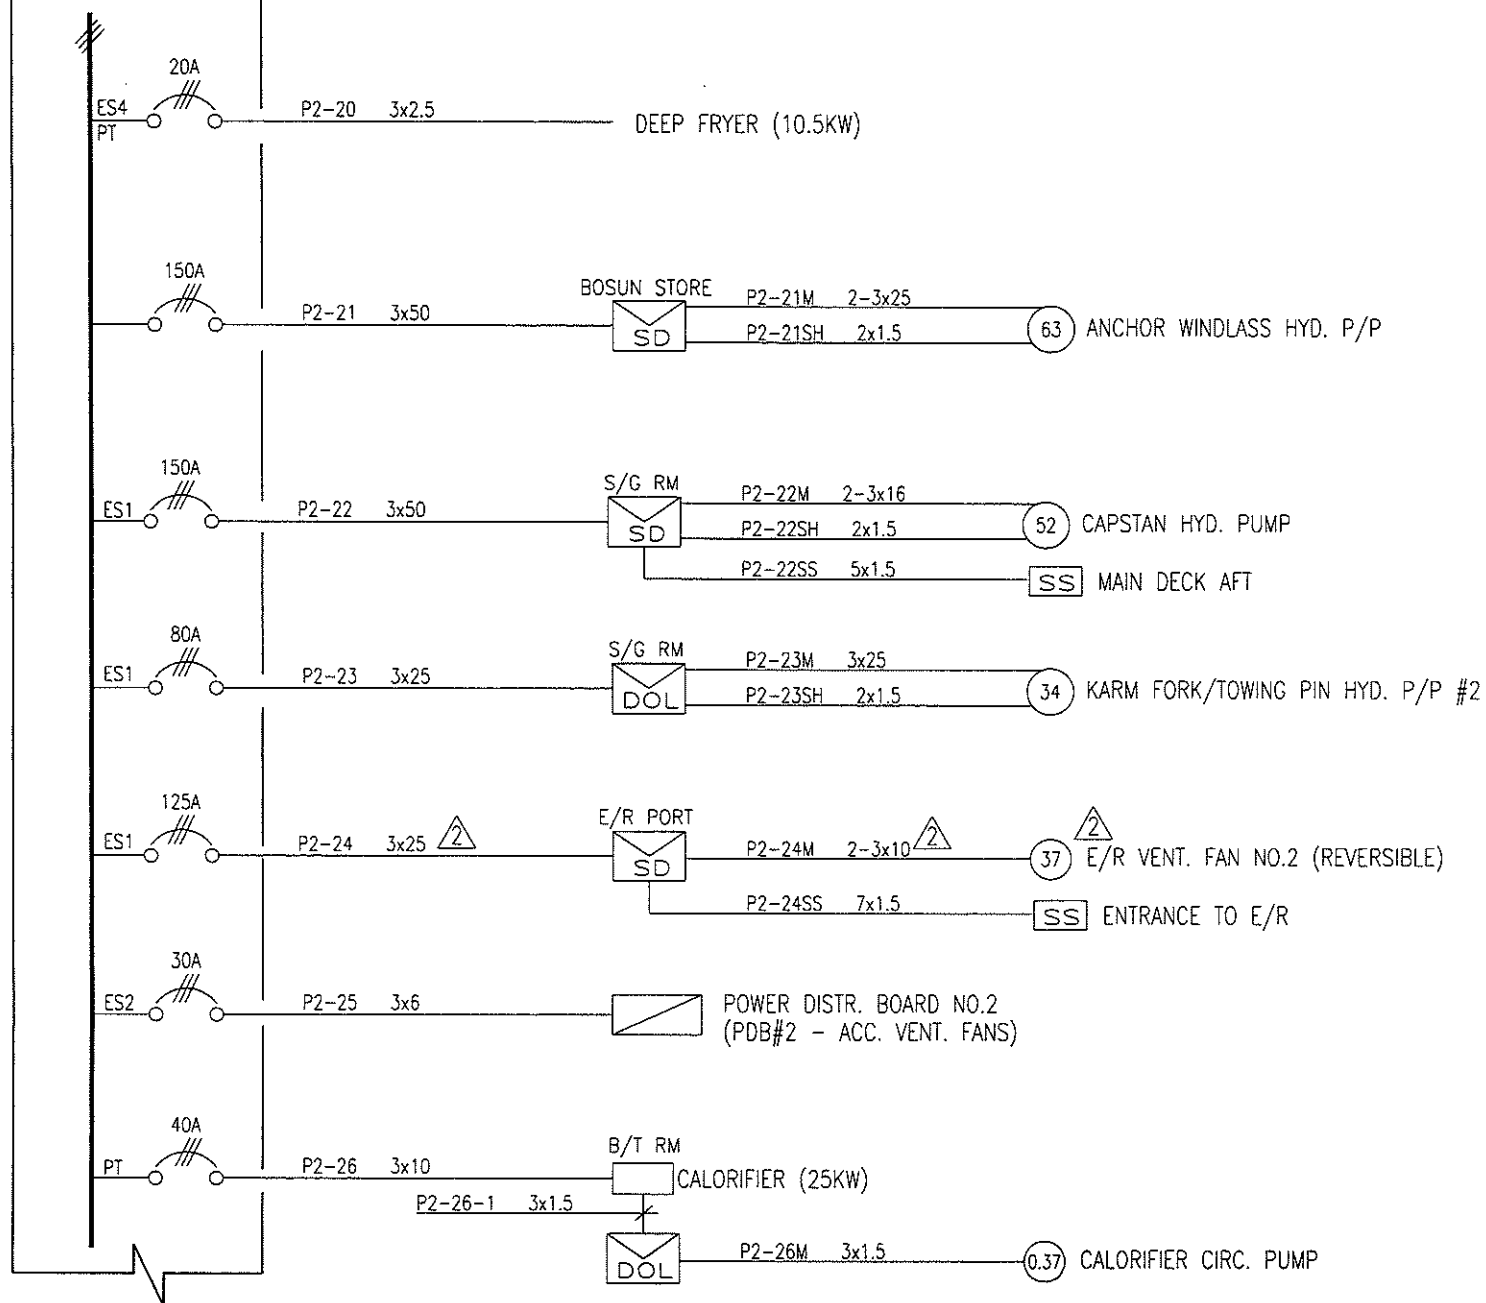

Pan-United Marine Limited	
PROJECT : 70M 12,000BHP AHTS VESSEL	
TITLE : SINGLE LINE DIAGRAM - MAIN SWBD (NO.2 440/3/60 DISTR. PANEL)	
PROJECT NO : HULL 165/169	SCALE : NA
DRAWING NO : E102	SHEET : 14 OF 18