

Е	QUIPMENT/F	DET	TAILS										
ITEM	TYPE	CAPA		DIFF. HEAD	LOCA	ATION							
				(BAR)			REFERENCE DRAWING/DOCUMENT						
BILGE/BALLAST	CENTRIFUGAL	60m		6	ENGINE		DRAWI	ING No.	Rev.	DRAWING TITLE			
/FIRE PUMP	PUMP						GSPL-P1482-P	1-0004	0		/ & F.W SI PIPING SCI		
BILGE/G.S/FIRE PUMP	CENTRIFUGAL PUMP	60m³/hr		6	RC	OOM .			COMPRESSED AIR SYSTEM			-	
BWTS SYSTEM	UV TREATMENT	60m³/hr		_			GSPL-P1482-PI-0003		0	(CONTROL AIR) PIPING SCHEMATIC			
	DESIGN CONDITION		TESTING		TESTING NOW		PIPE	FITTI	INGS/FLANGE	/FLANGE			
1		1									1		- It


BWTS SYSTEM	UV TREA	TMENT	60m³/hr	_			0012 11102 1	1 0000		SCHEMAT	TIC							
DESIGN CONDITION			TESTING			PIPE	FITTINGS/FLANGE				VA	VALVE						
SYSTEM	PRESSURE (bar)	TEMP. (°C)	CLASS MEDIU	M PRESS	URE	NOM. DIA.	MATERIAL & SCHEDULE	MATERIAL (FITTINGS)	MATERIAL (FLANGES)	FLANGE RATING	GASKET COATING	MATE BODY	TRIM	REMARKS				
					3	300A	UC 07454									ITEM	LIST	
						TO 600A	JIS G3454 STPG370,Sch40		JIS B2220 SF440	JIS 5K /PN10	NON HOT-DIP ASBESTOS GALVANIZED				No.	ITEM	ITEM NO.	REMARKS
						200A TO 250A 50A	JIS G3454 STPG370,Sch40	JIS B2312 PG370	JIS B2220 SF440	JIS 5K/ PN10		CAST	AL. BRONZE		1	PIPE	BA01-BA06	
BWTS	6	AMB	III WATER	R 9						11110	NON HOT-DIP ASBESTOS GALVANIZED				2	VALVE	BAV01-BAV11	
					TO 150A		JIS G3454 STPG370,Sch40	JIS B2312 PG370	JIS B2220	JIS 5K/			BRONZE		3	SAMPLING DEVICE	SV	
						TO 40A	PG3/0	SF440	PN10		BRONZE			4	FLOW METER	FT		

Symbol	Name		NOTES			
	BWTS Line BWTS Control & Auxiliary Air Line		VALVE ACTUATION MEANS IS PROVIDED VIA INSTRUMENT AIR			
			QUALITY AND PRESSURE OF COMPRESSED AIR SHALL MEET			
	Pressure reducing valve	3	BWTS MAKER STANDARDS  VALVES MARKED WITH ** SYMBOL TO BE MONITORED DURING BWTS OPERATION.			
	Electropneumatic ball valve	4	VALVE BAVO8 ACT AS BYPASS VALVE FOR THE BWTS.			
	Electropneumatic butterfly valve	5	THE SPILLAGE LINE SUITABLY ROUTED TO NEAR BILGE WELL/SCUPPER			
兩	Manual valve	6	REFER BIOSEA BWTS (OMSM)			
	Electropneumatic control valve					
楼	Pressure safety valve					
<del> </del>	Vent					
Q	Sensor					
(F)	Flowmeter					
otin  oti	Centrifugal pump					
	Flexible sleeve					
	Ejector or eductor					
<del> </del>	Butterfly valve					
	Check Valve					
	Air Filter					



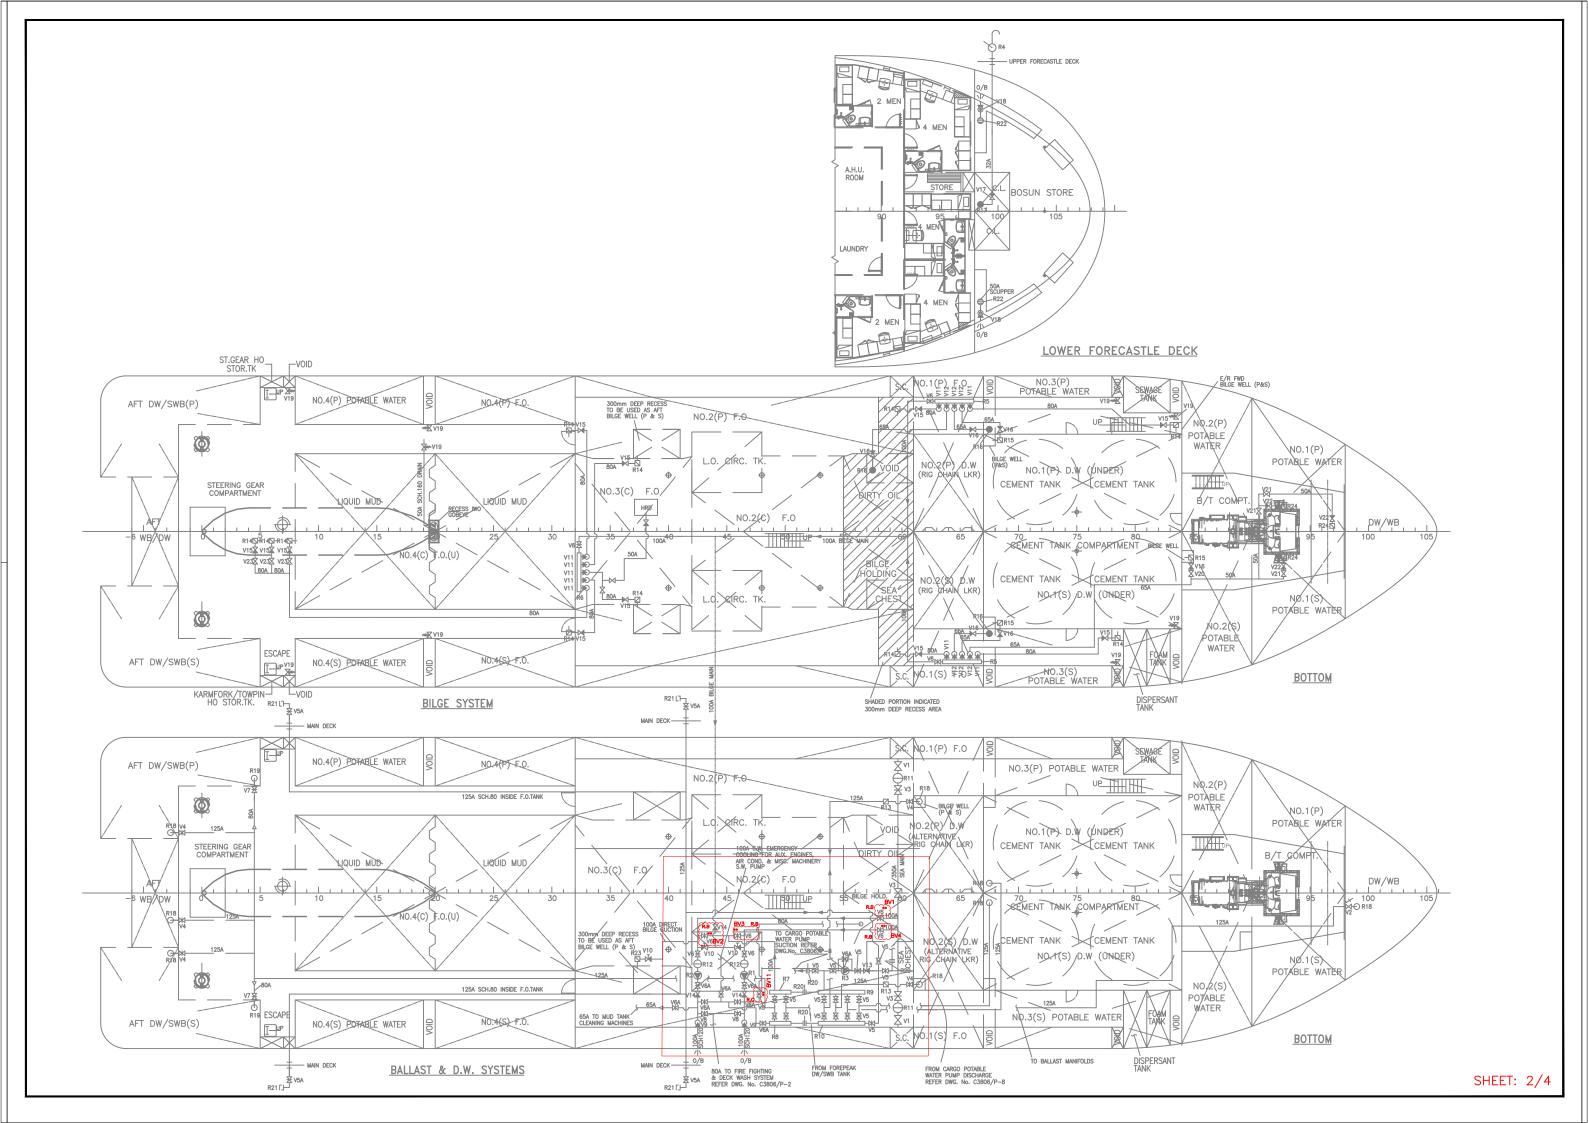

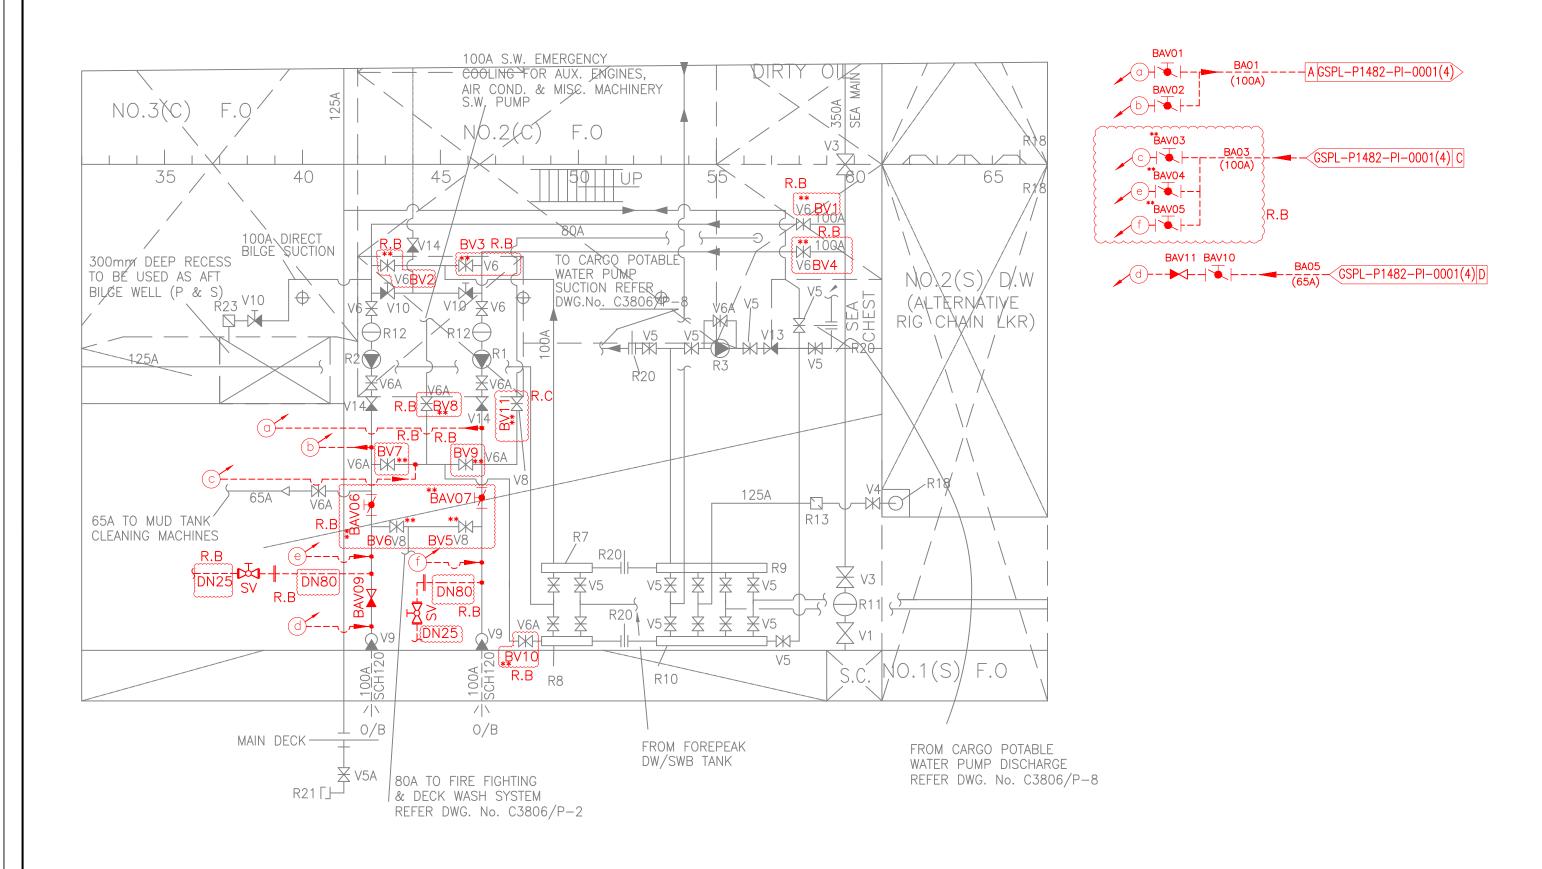

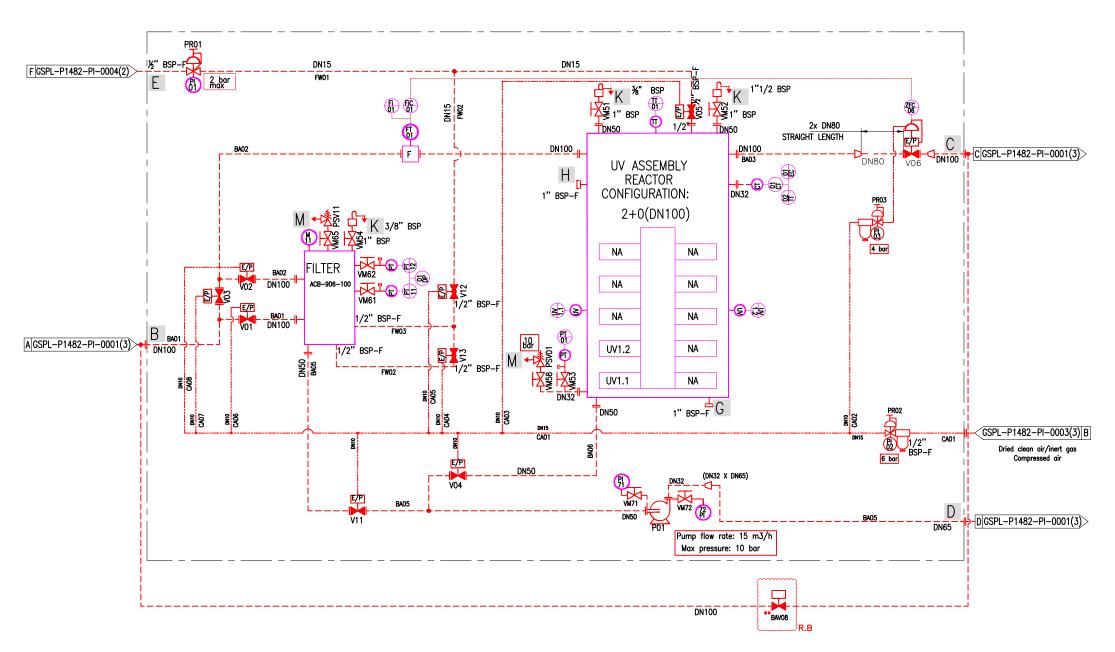

В	Main water inlet
С	Main water outlet
D	Water discharge (backwash & draining)
Ε	Fresh water inlet
F	Air inlet
G	"To CIP inlet" connection
Н	"From CIP outlet" connection
ı	"To Stripping ejector" connection
J	"From Stripping ejector"
K	Vent outlet to gutter or bilge water
М	Saferty valve outlet to gutter or bilge water

СТ	Conductivity transmitter	PR	Pressure reducing valve
DP	Differential pressure	PSV	Pressure safety valve
EC	Electrical conductivity	PT	Pressure transmitter
F	Flow sensor	π	Temperature transmitter
Fi	Flow information	UV	UV irradiance
FiC	Flow control	٧	Valve
FT	Flow transmitter	VM	Manual valve
HA	Visual and audible alarm	ZEC	Control valve opening
Р	Pump		
PI	Pressure indicator (indicative values, for information only)		